




527,0 m²

Plan 1

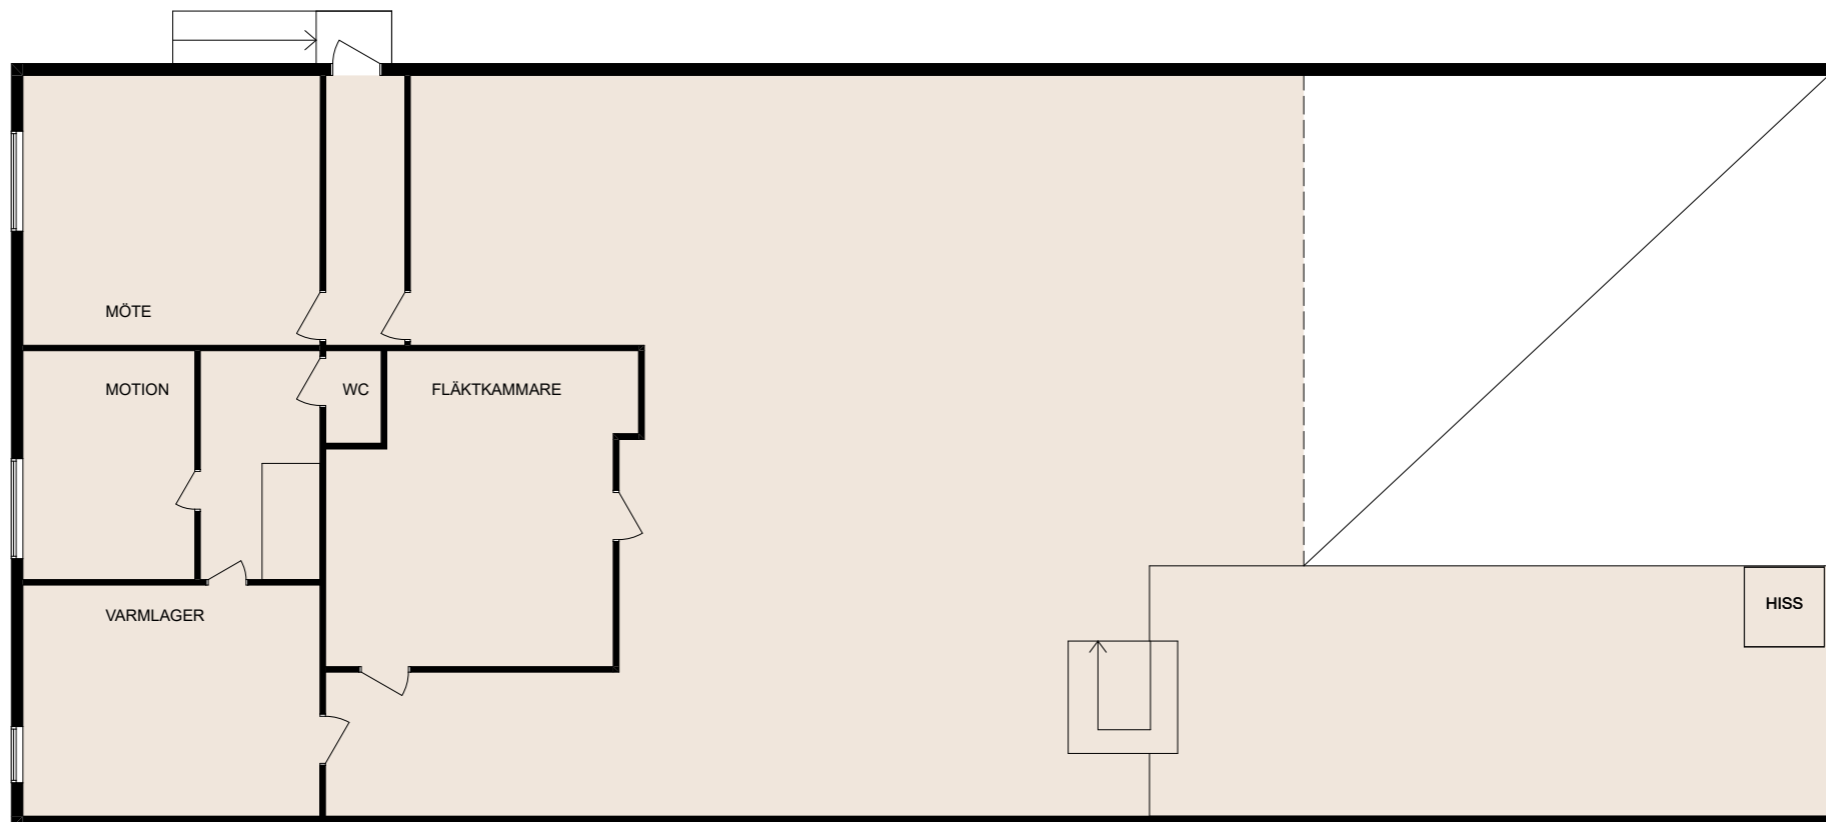

425,4 m²

Plan 0

MÄRSTA 11.13
Generatorgatan 8

A3 1:100
Relationsritningar

